

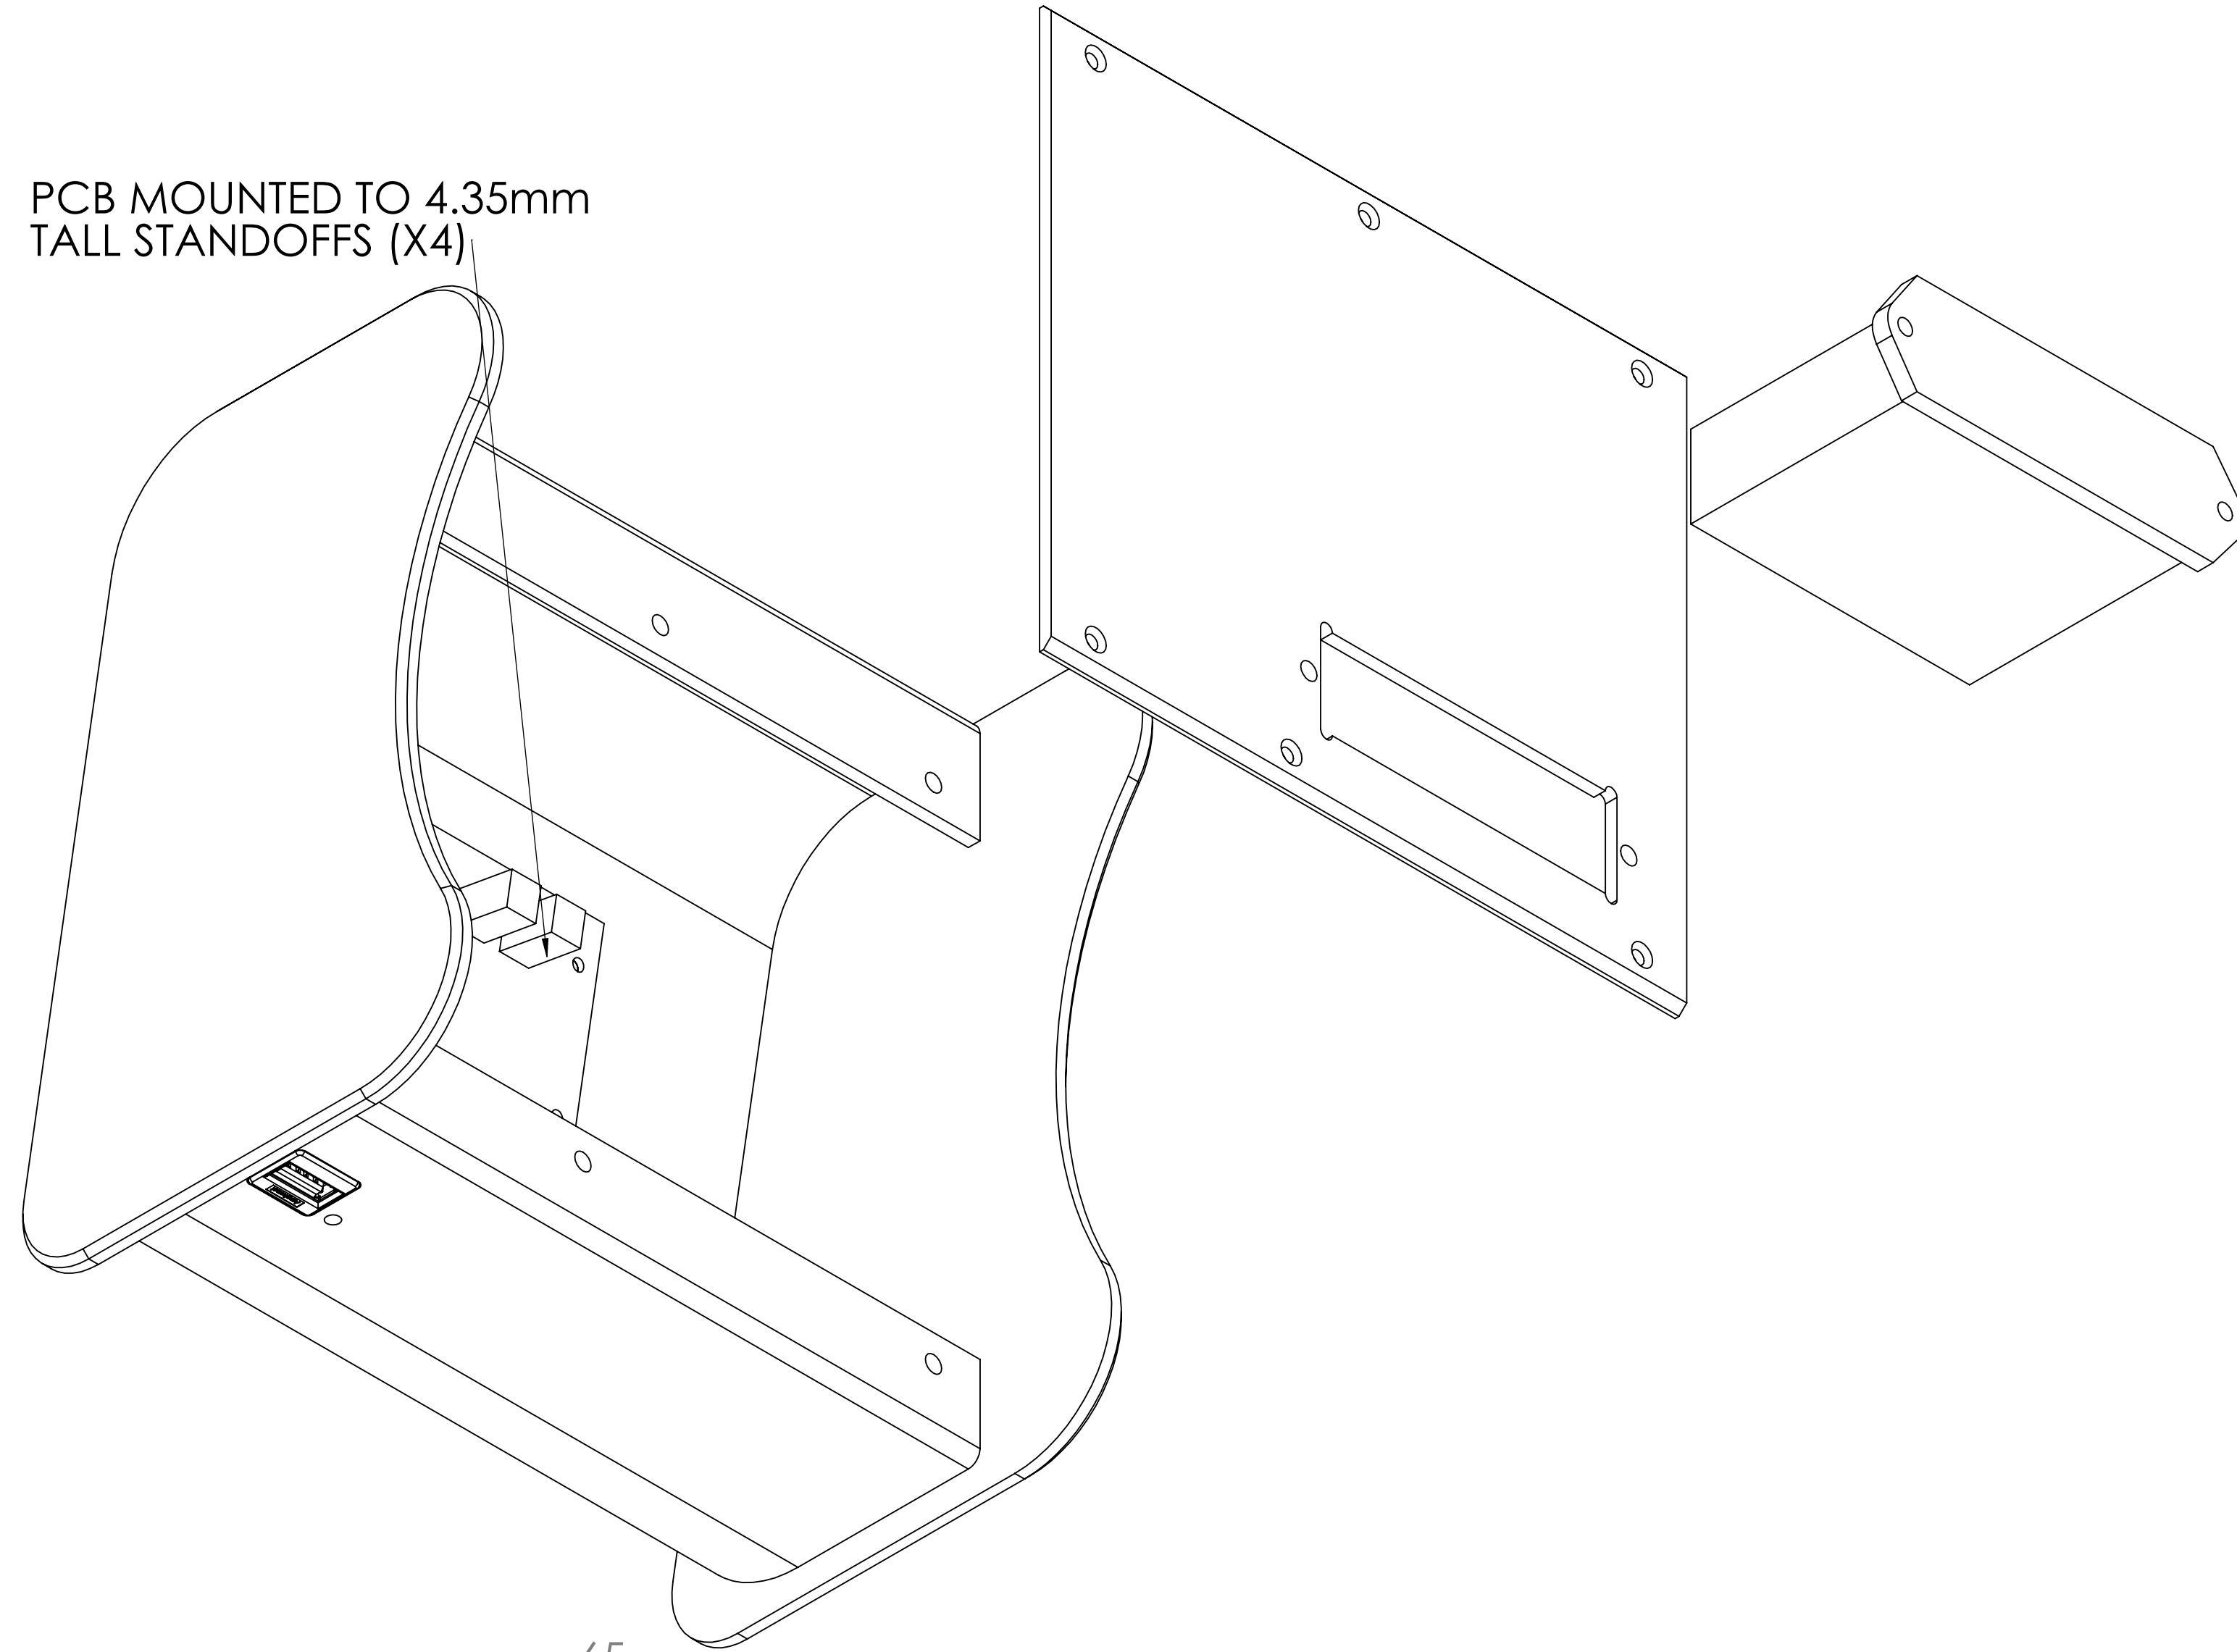
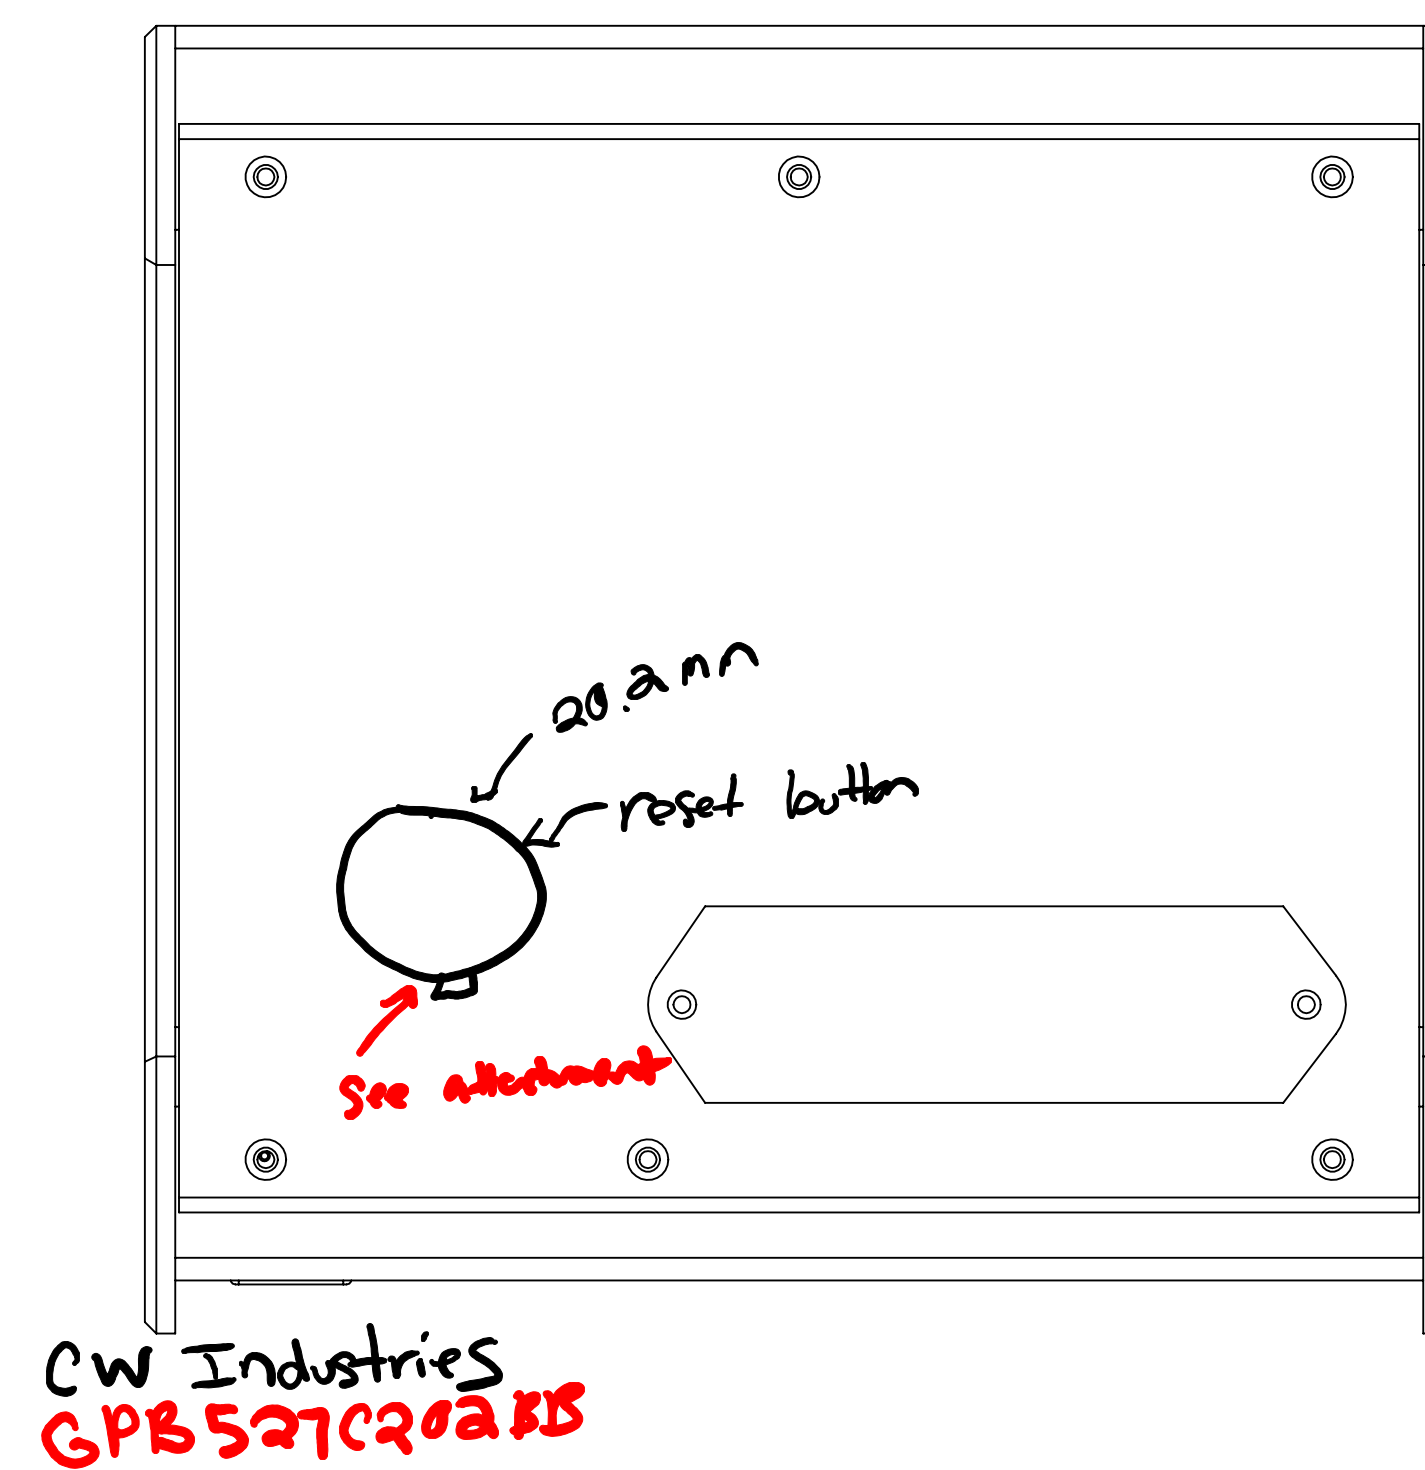
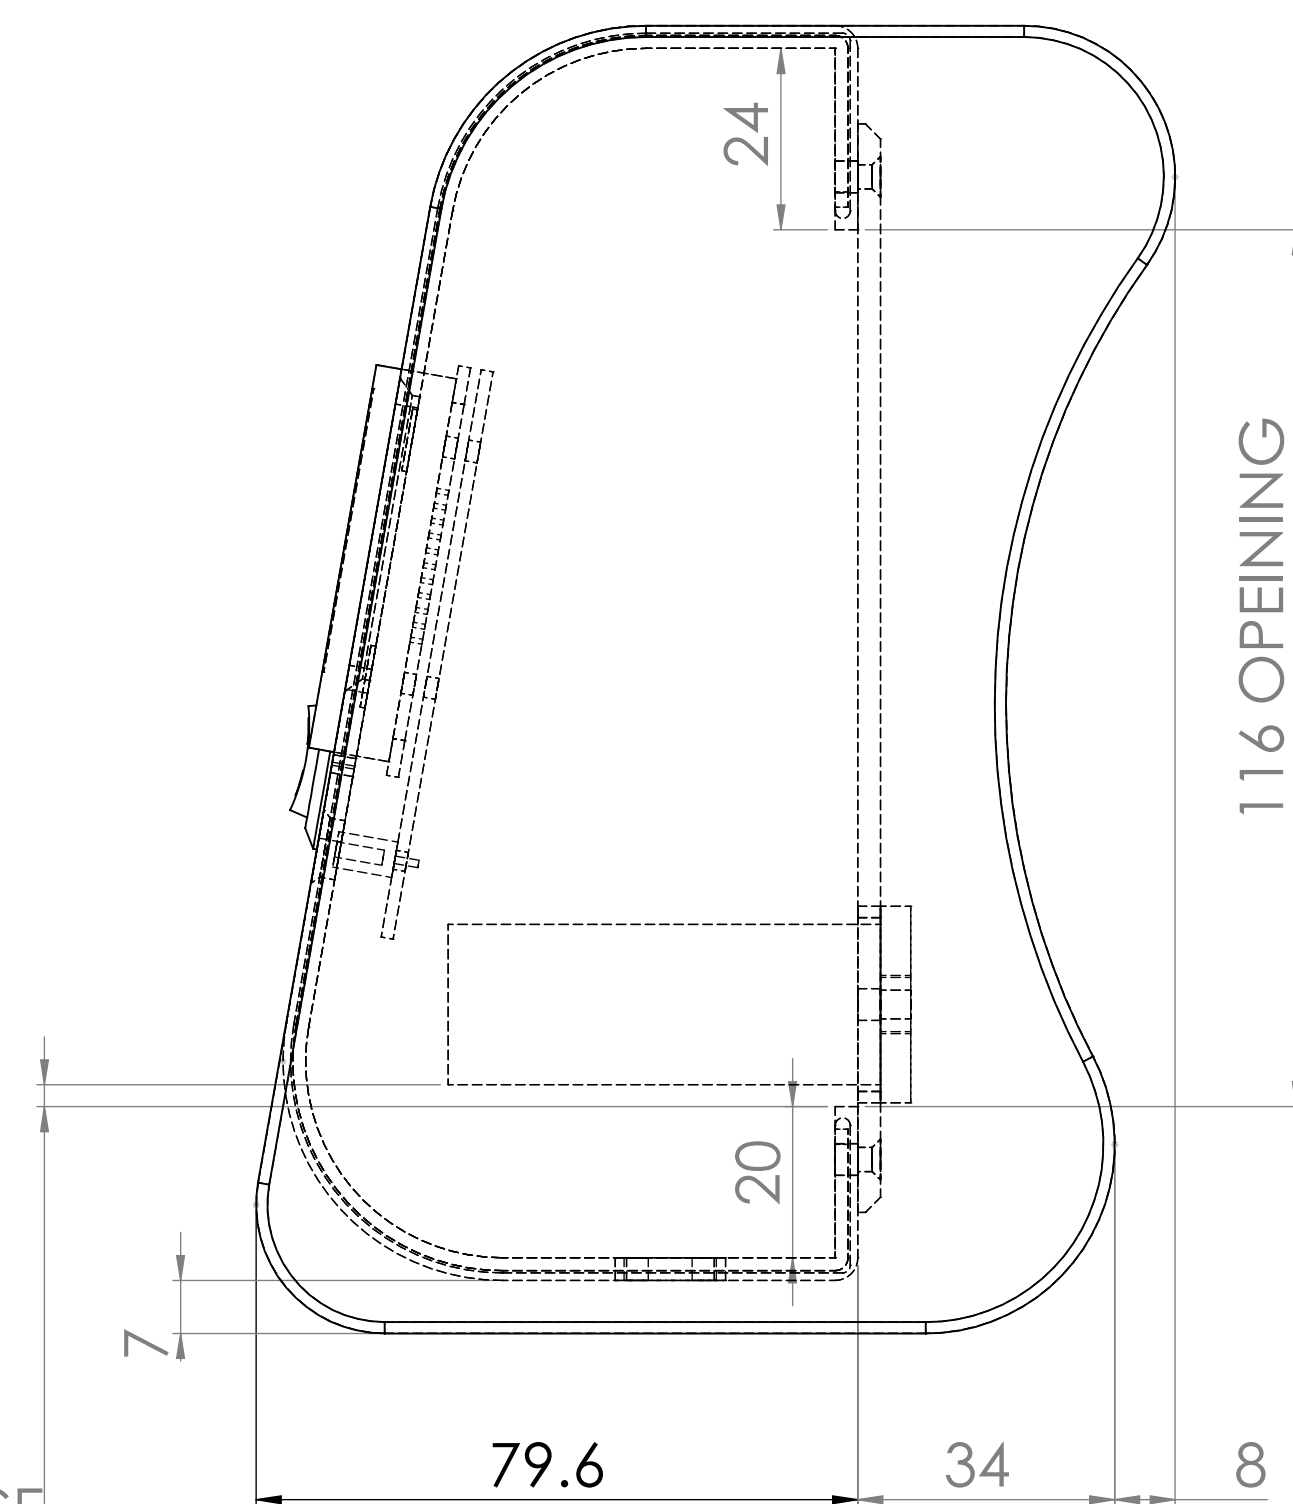


PCB MOUNTED TO 4.35mm
TALL STANDOFFS (X4)

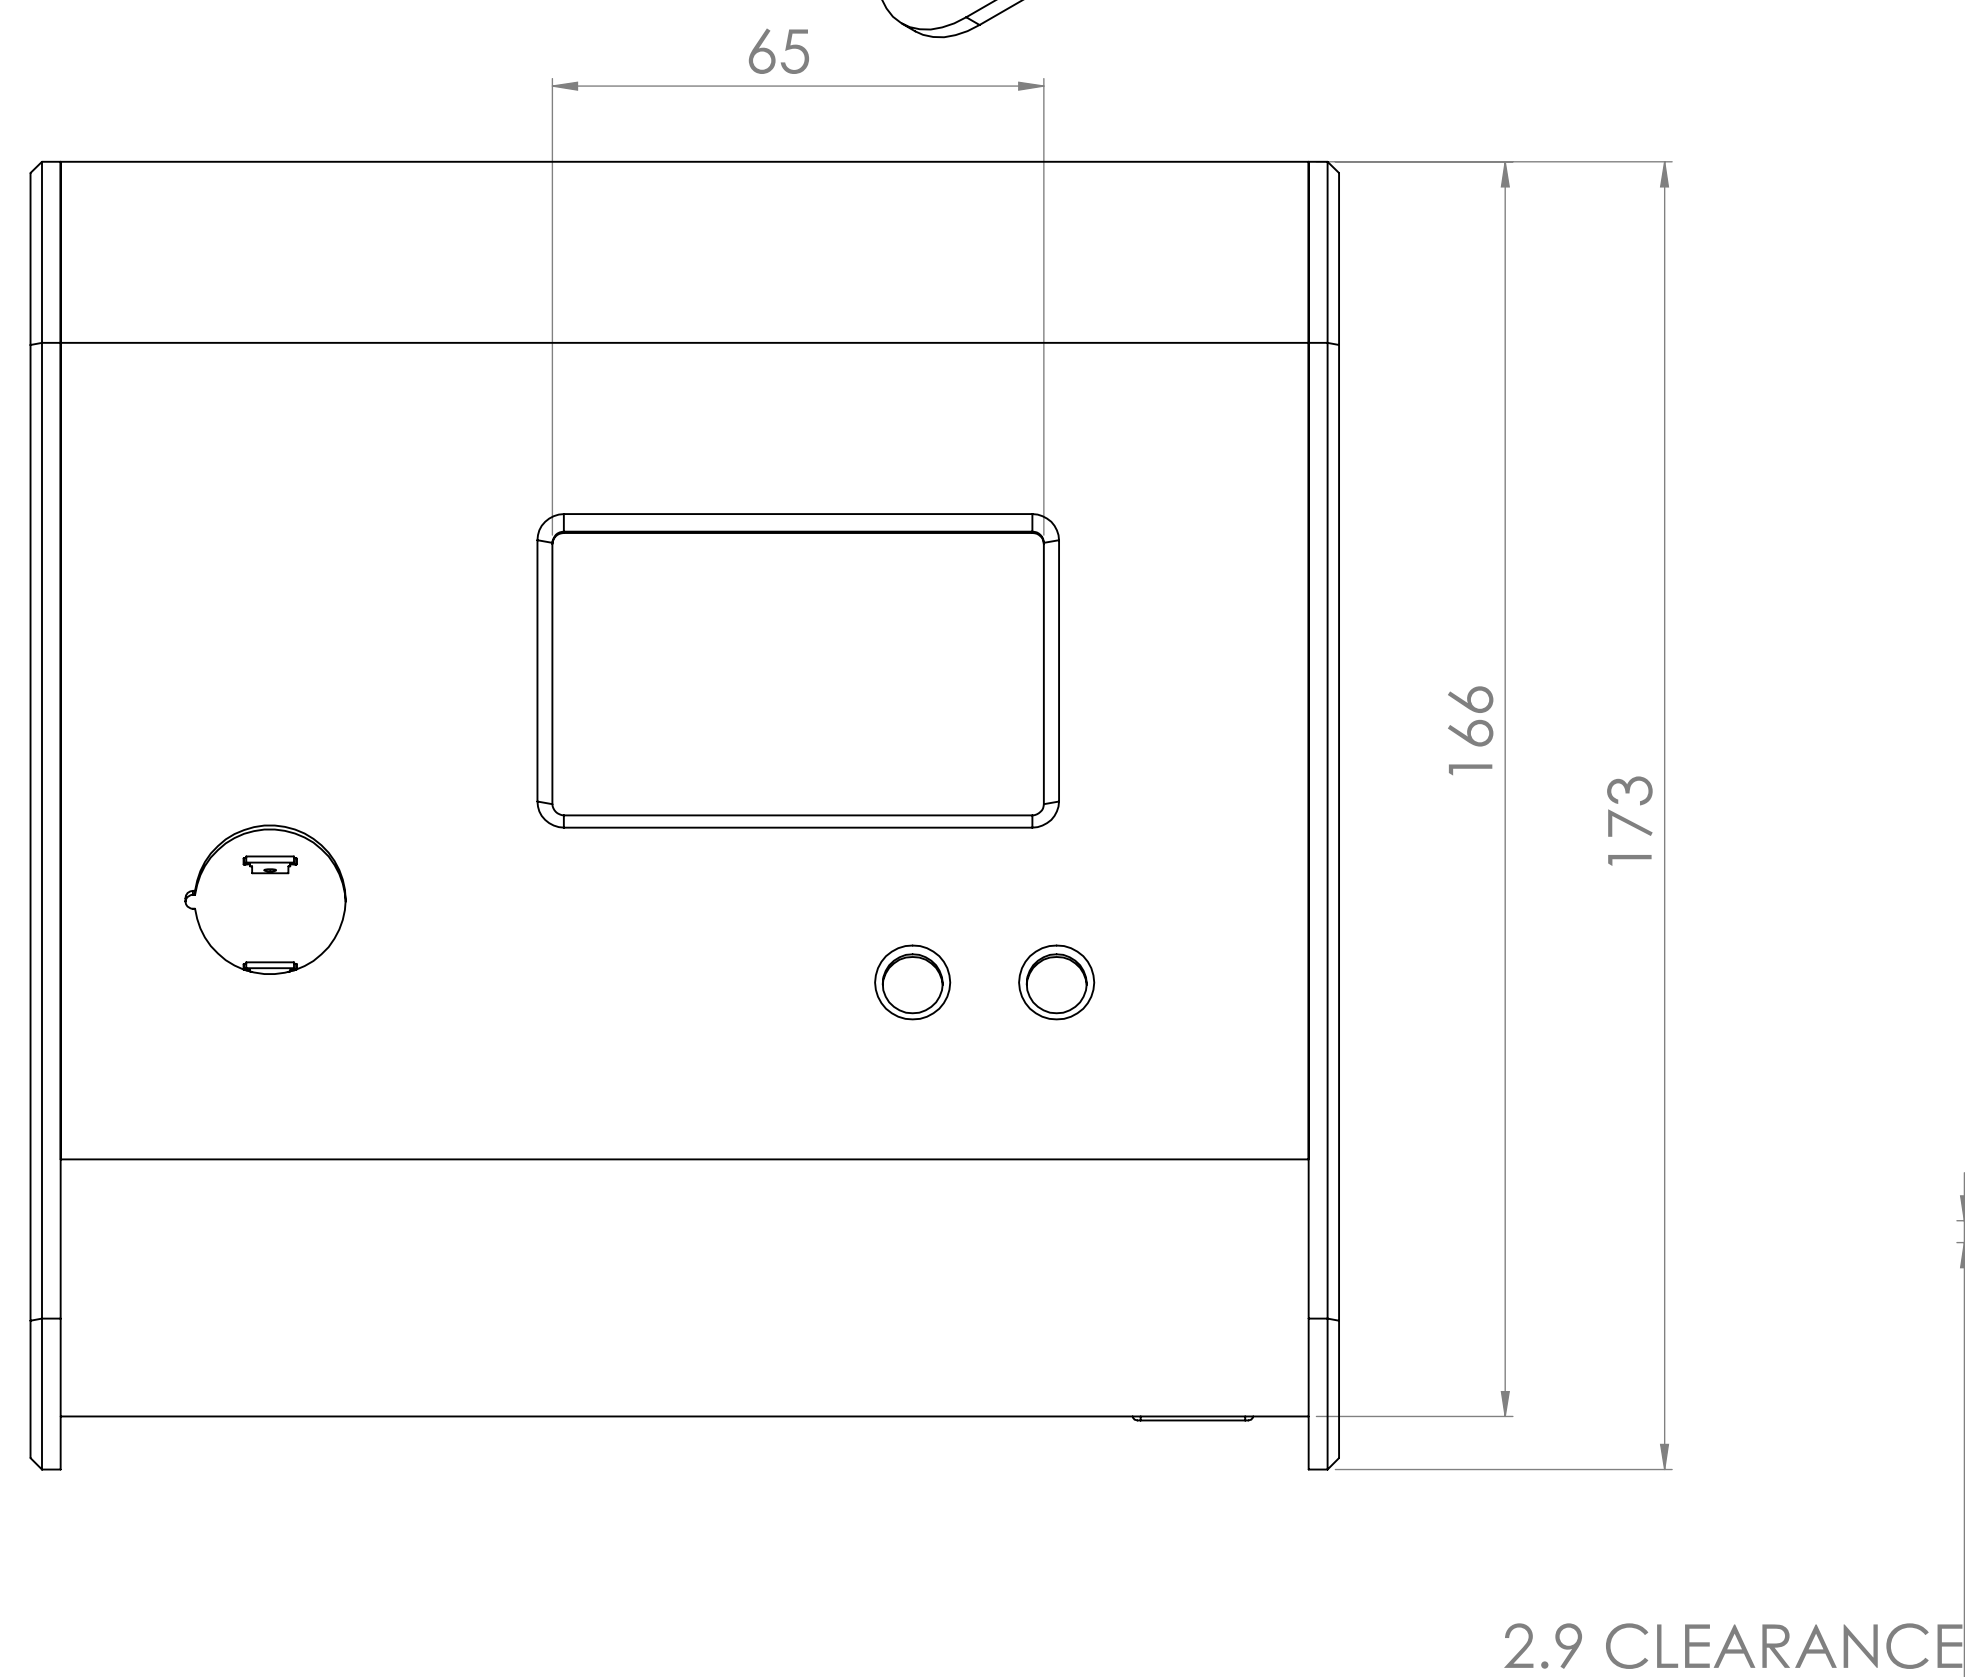



EACH STANDOFF HAS A M2.5 INSERT.

SCREWS INTENTIONALLY NOT SHOWN.
SCREWS TYPICALLY NOT SUPPLIED UNLESS
UPON REQUEST WITH MARKUP.

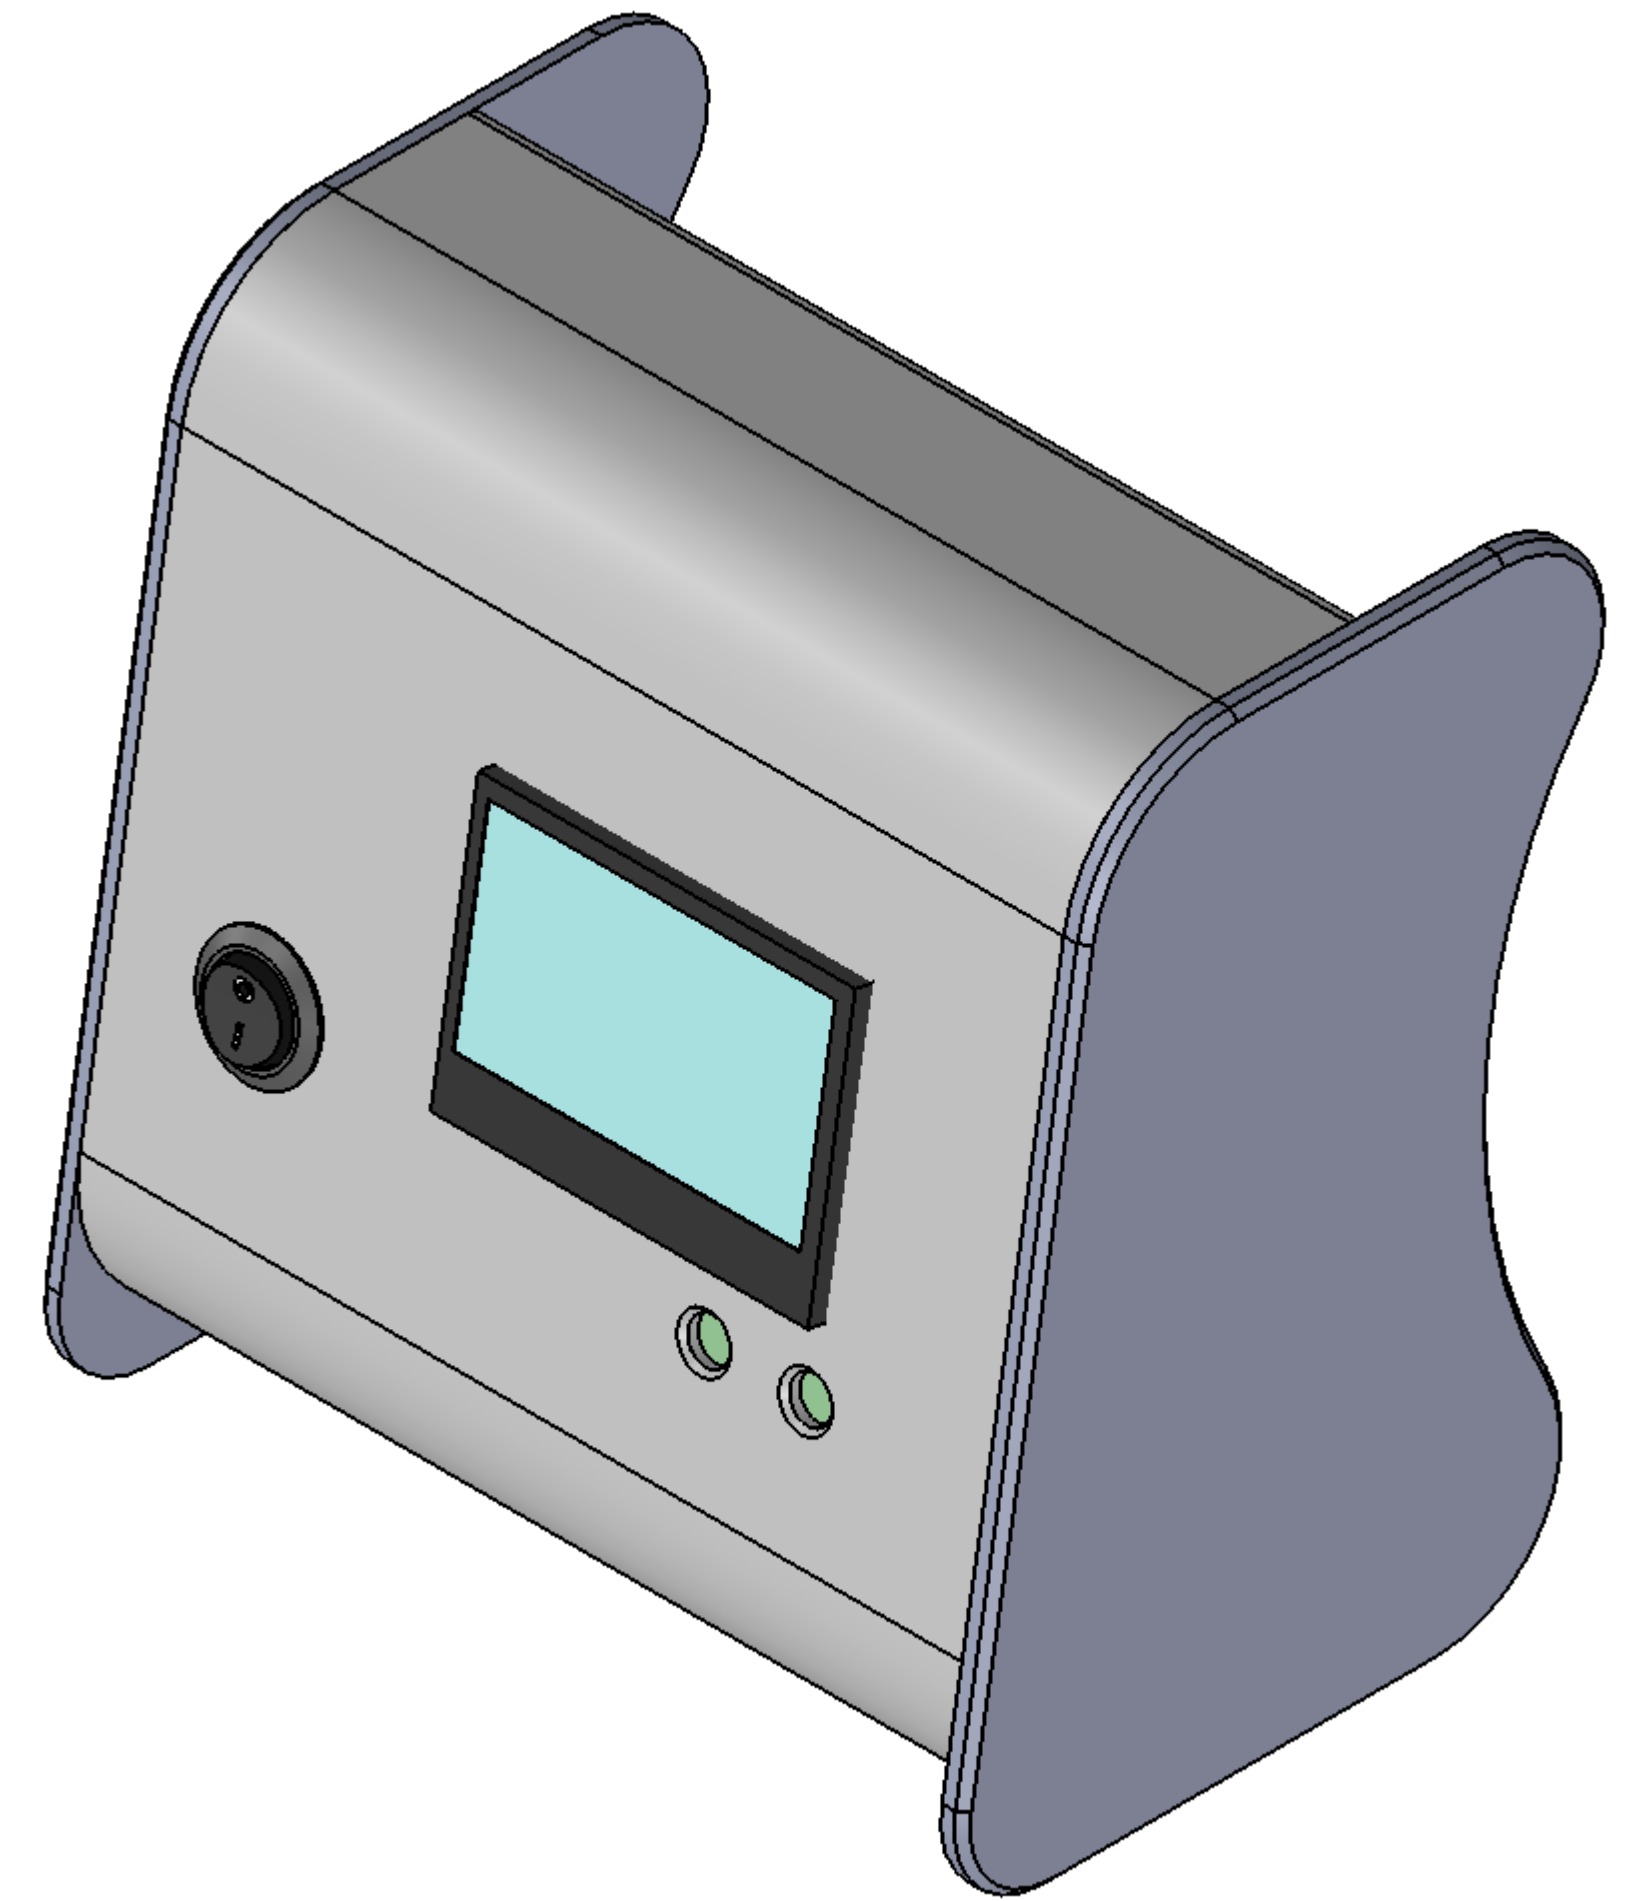


CW Industries
GPB527C202AB

TOOLLESS DRAWING
JOB# 6941
JOB NAME: CAROLON
PROJECT: SMART READER
DIMENSIONS IN mm
MATERIAL: OFF 3mm WHITE ABS,
4mm BLACK ABS
DESIGNER: SONYA BAILEY
DATE DRAWN: 12/15/2016
DATE UPDATED 01/13/2017
SHEET 1 OF 3

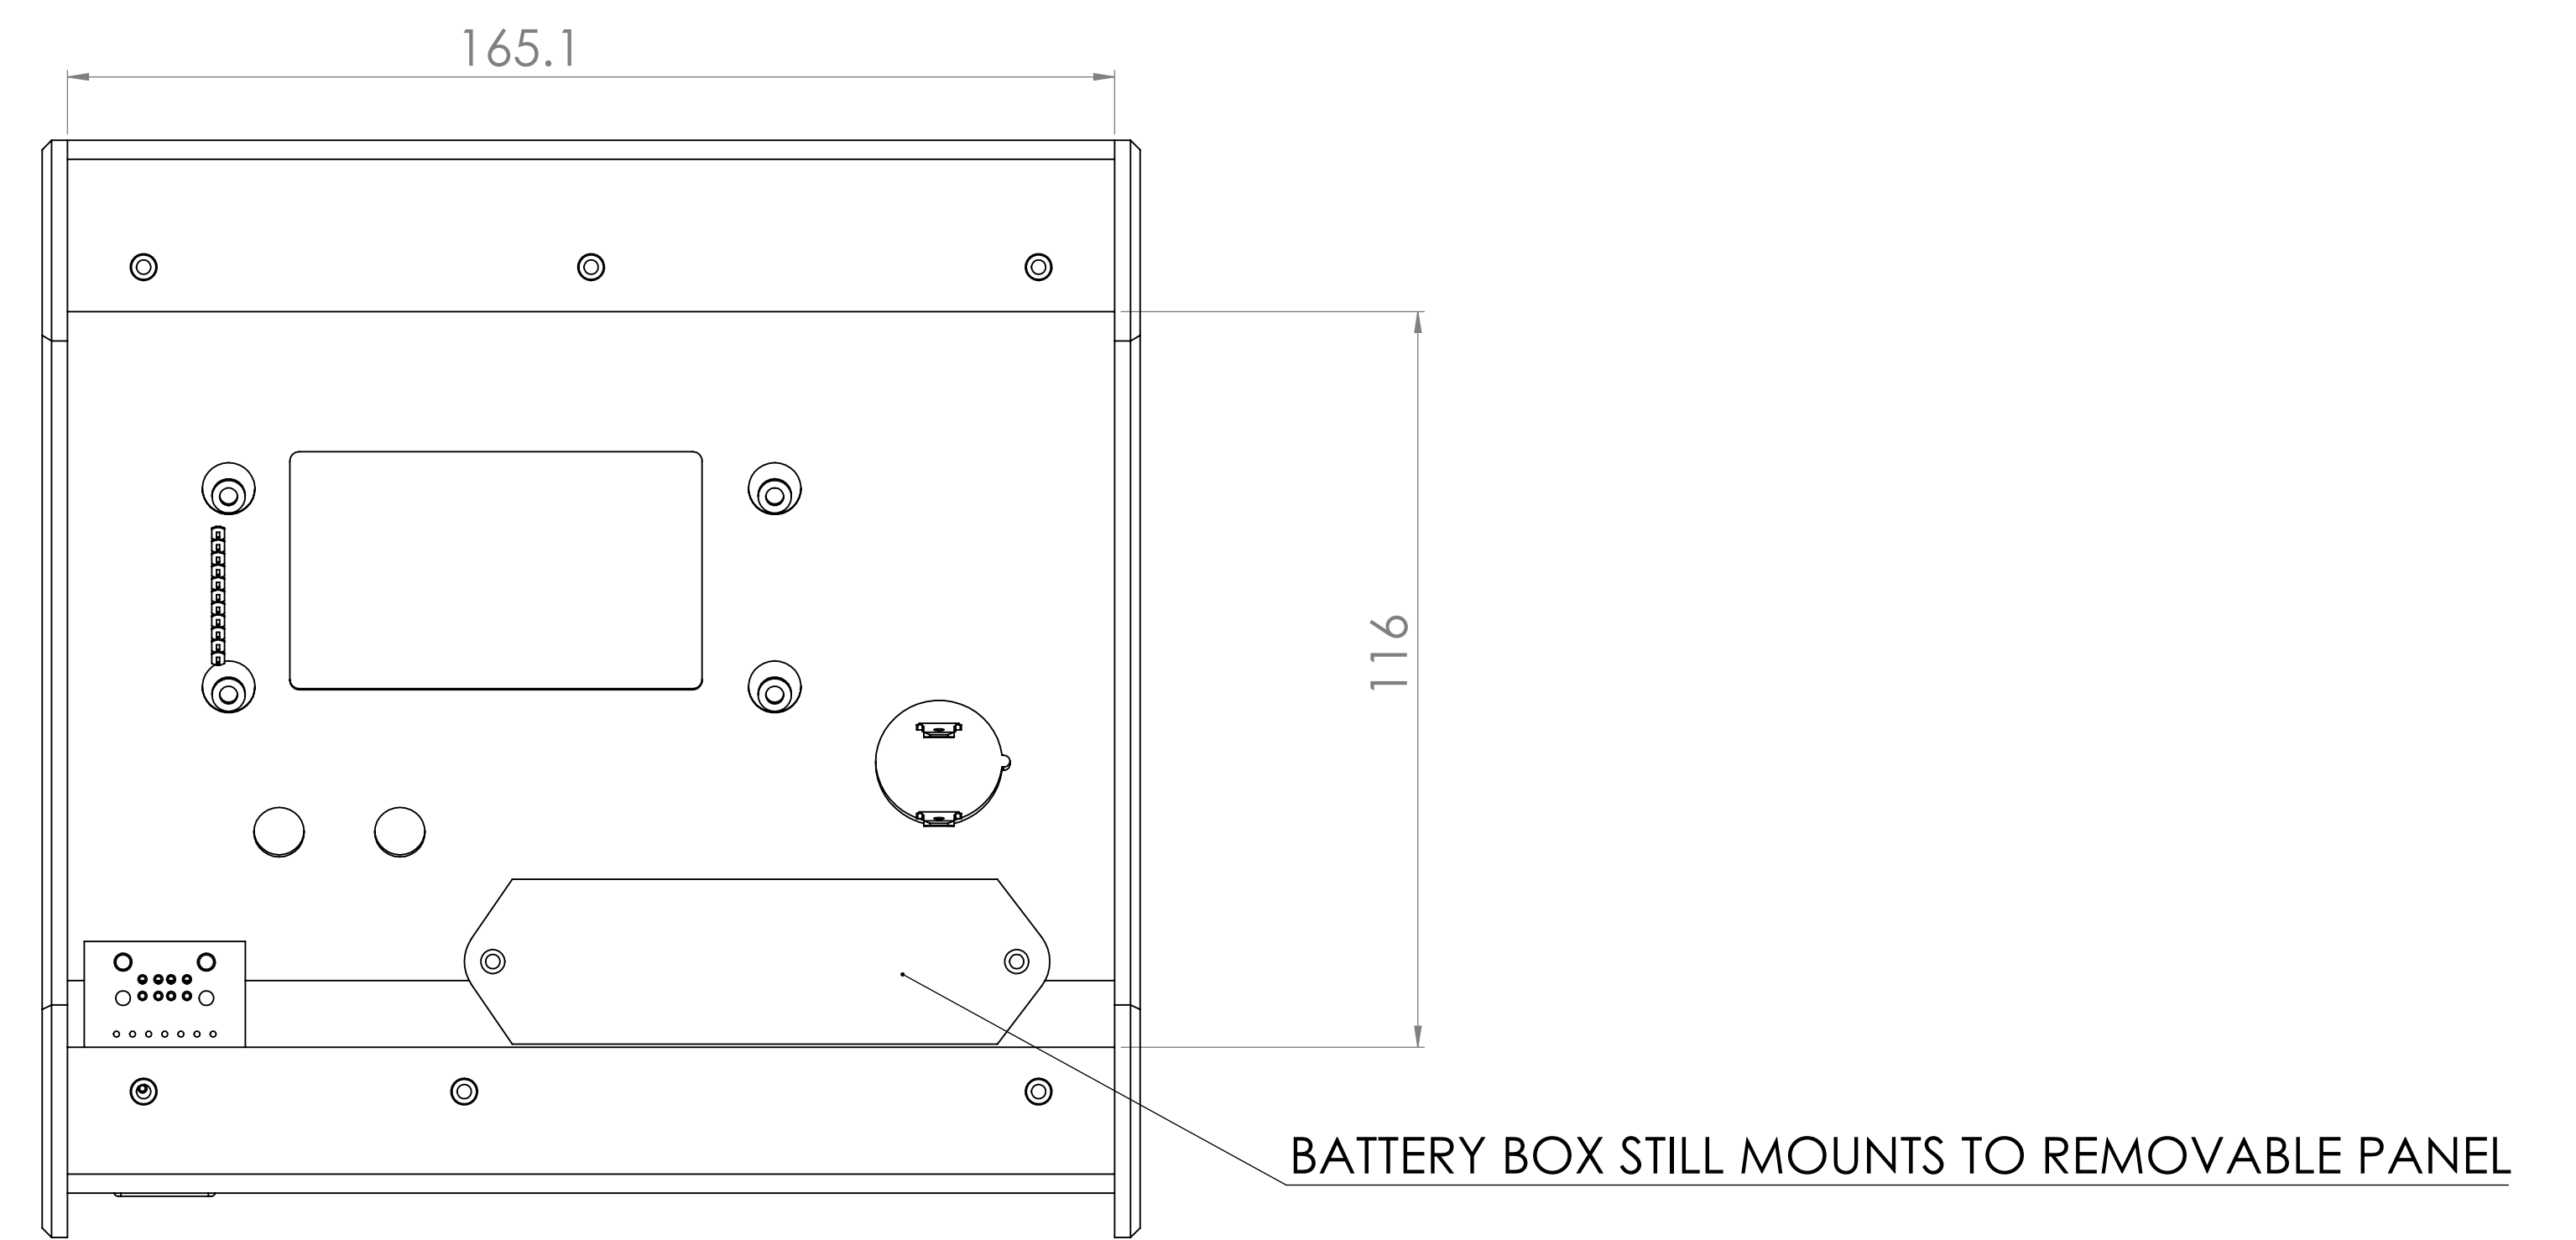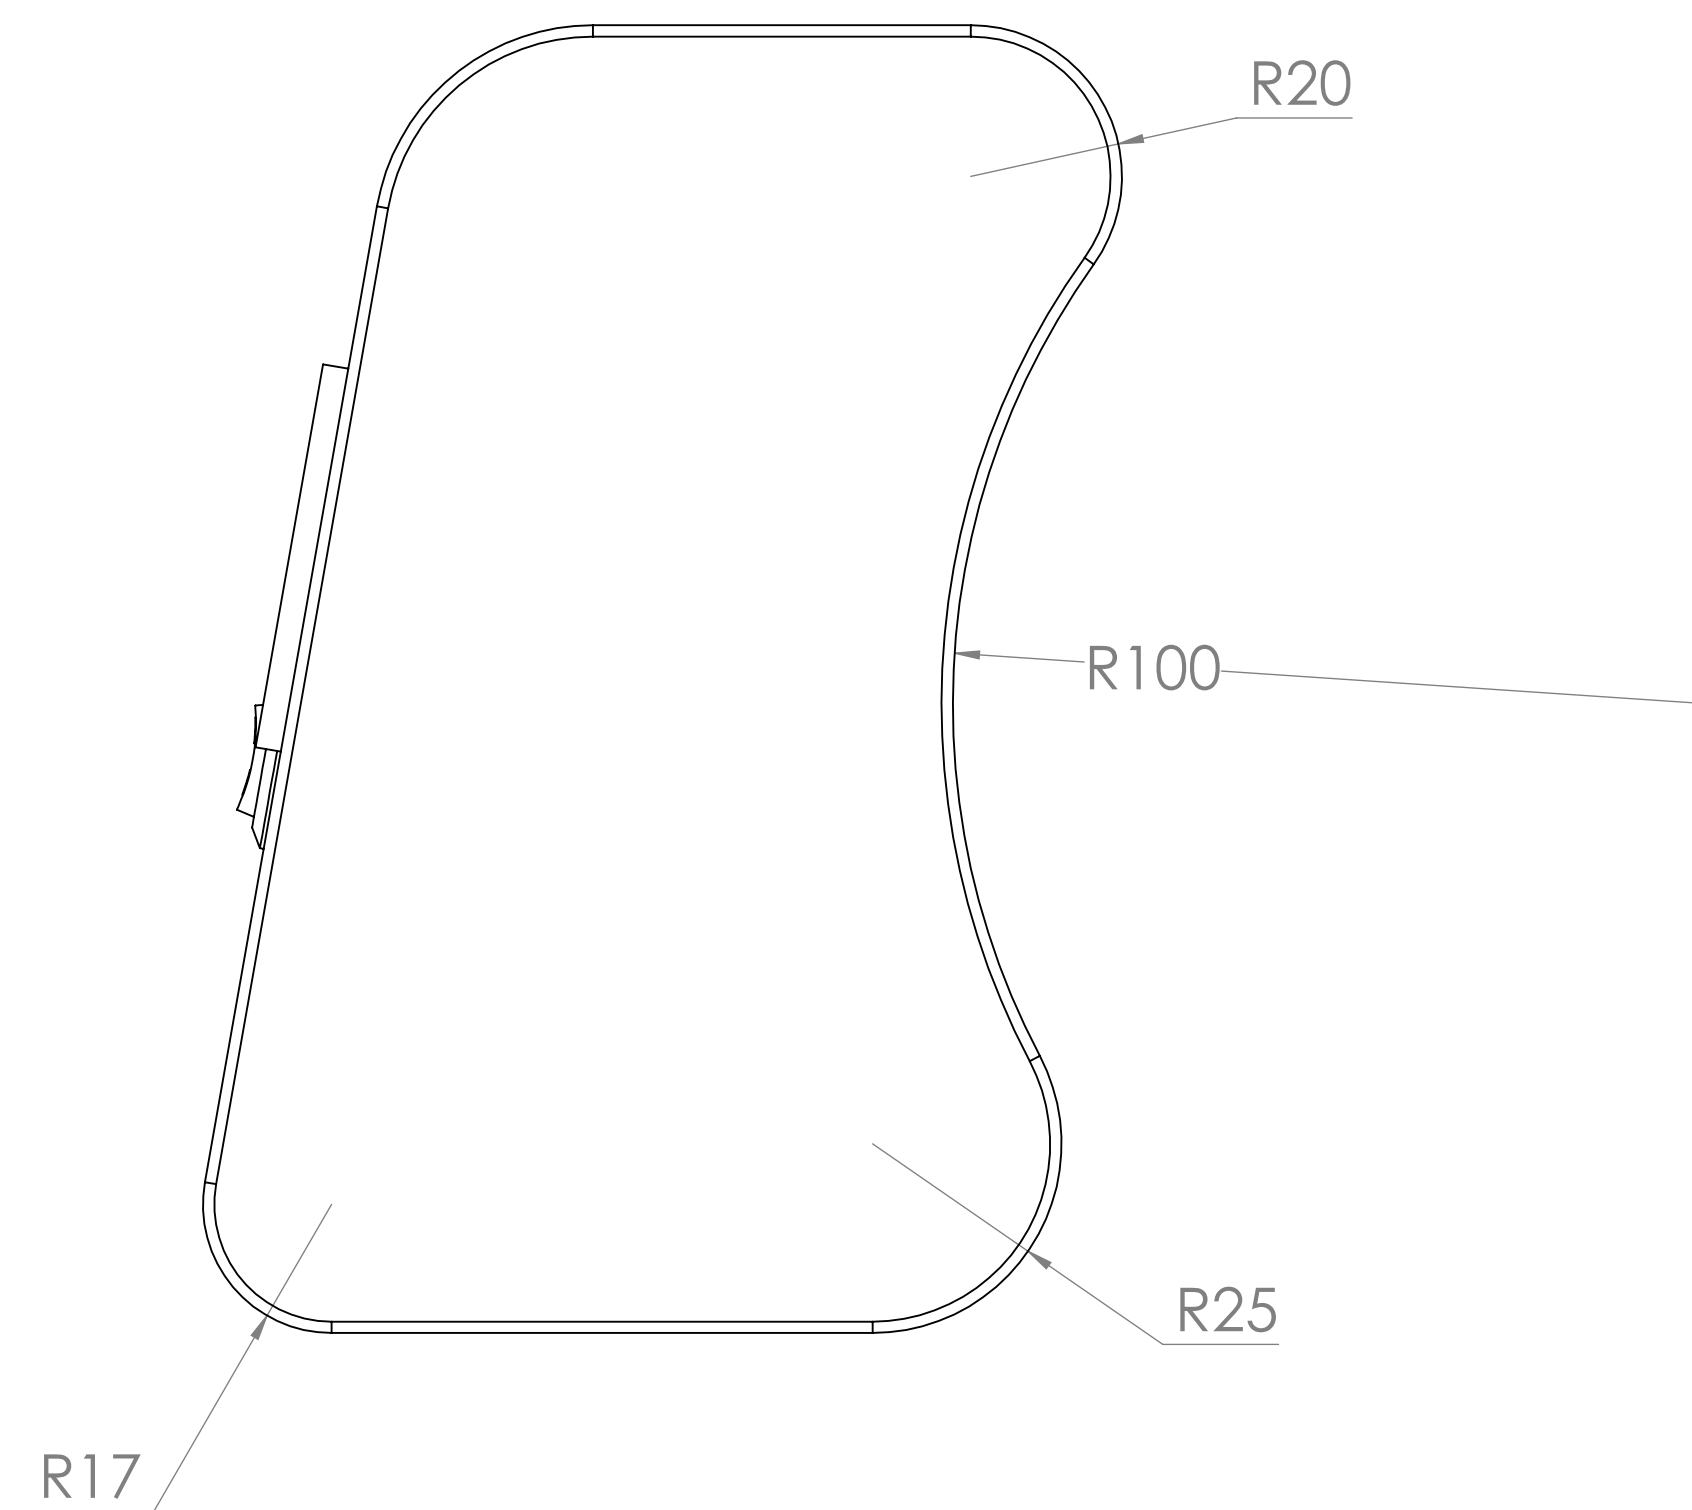

BACK VIEW
REMOVABLE PANEL NOT SHOWN

TOOLLESS DRAWING
JOB# 6941
JOB NAME: CAROLON
PROJECT: SMART READER
DIMENSIONS IN mm
MATERIAL: OFF 3mm WHITE ABS,
4mm BLACK ABS
DESIGNER: SONYA BAILEY
DATE DRAWN: 12/15/2016
DATE UPDATED 01/13/2017
SHEET 2 OF 3

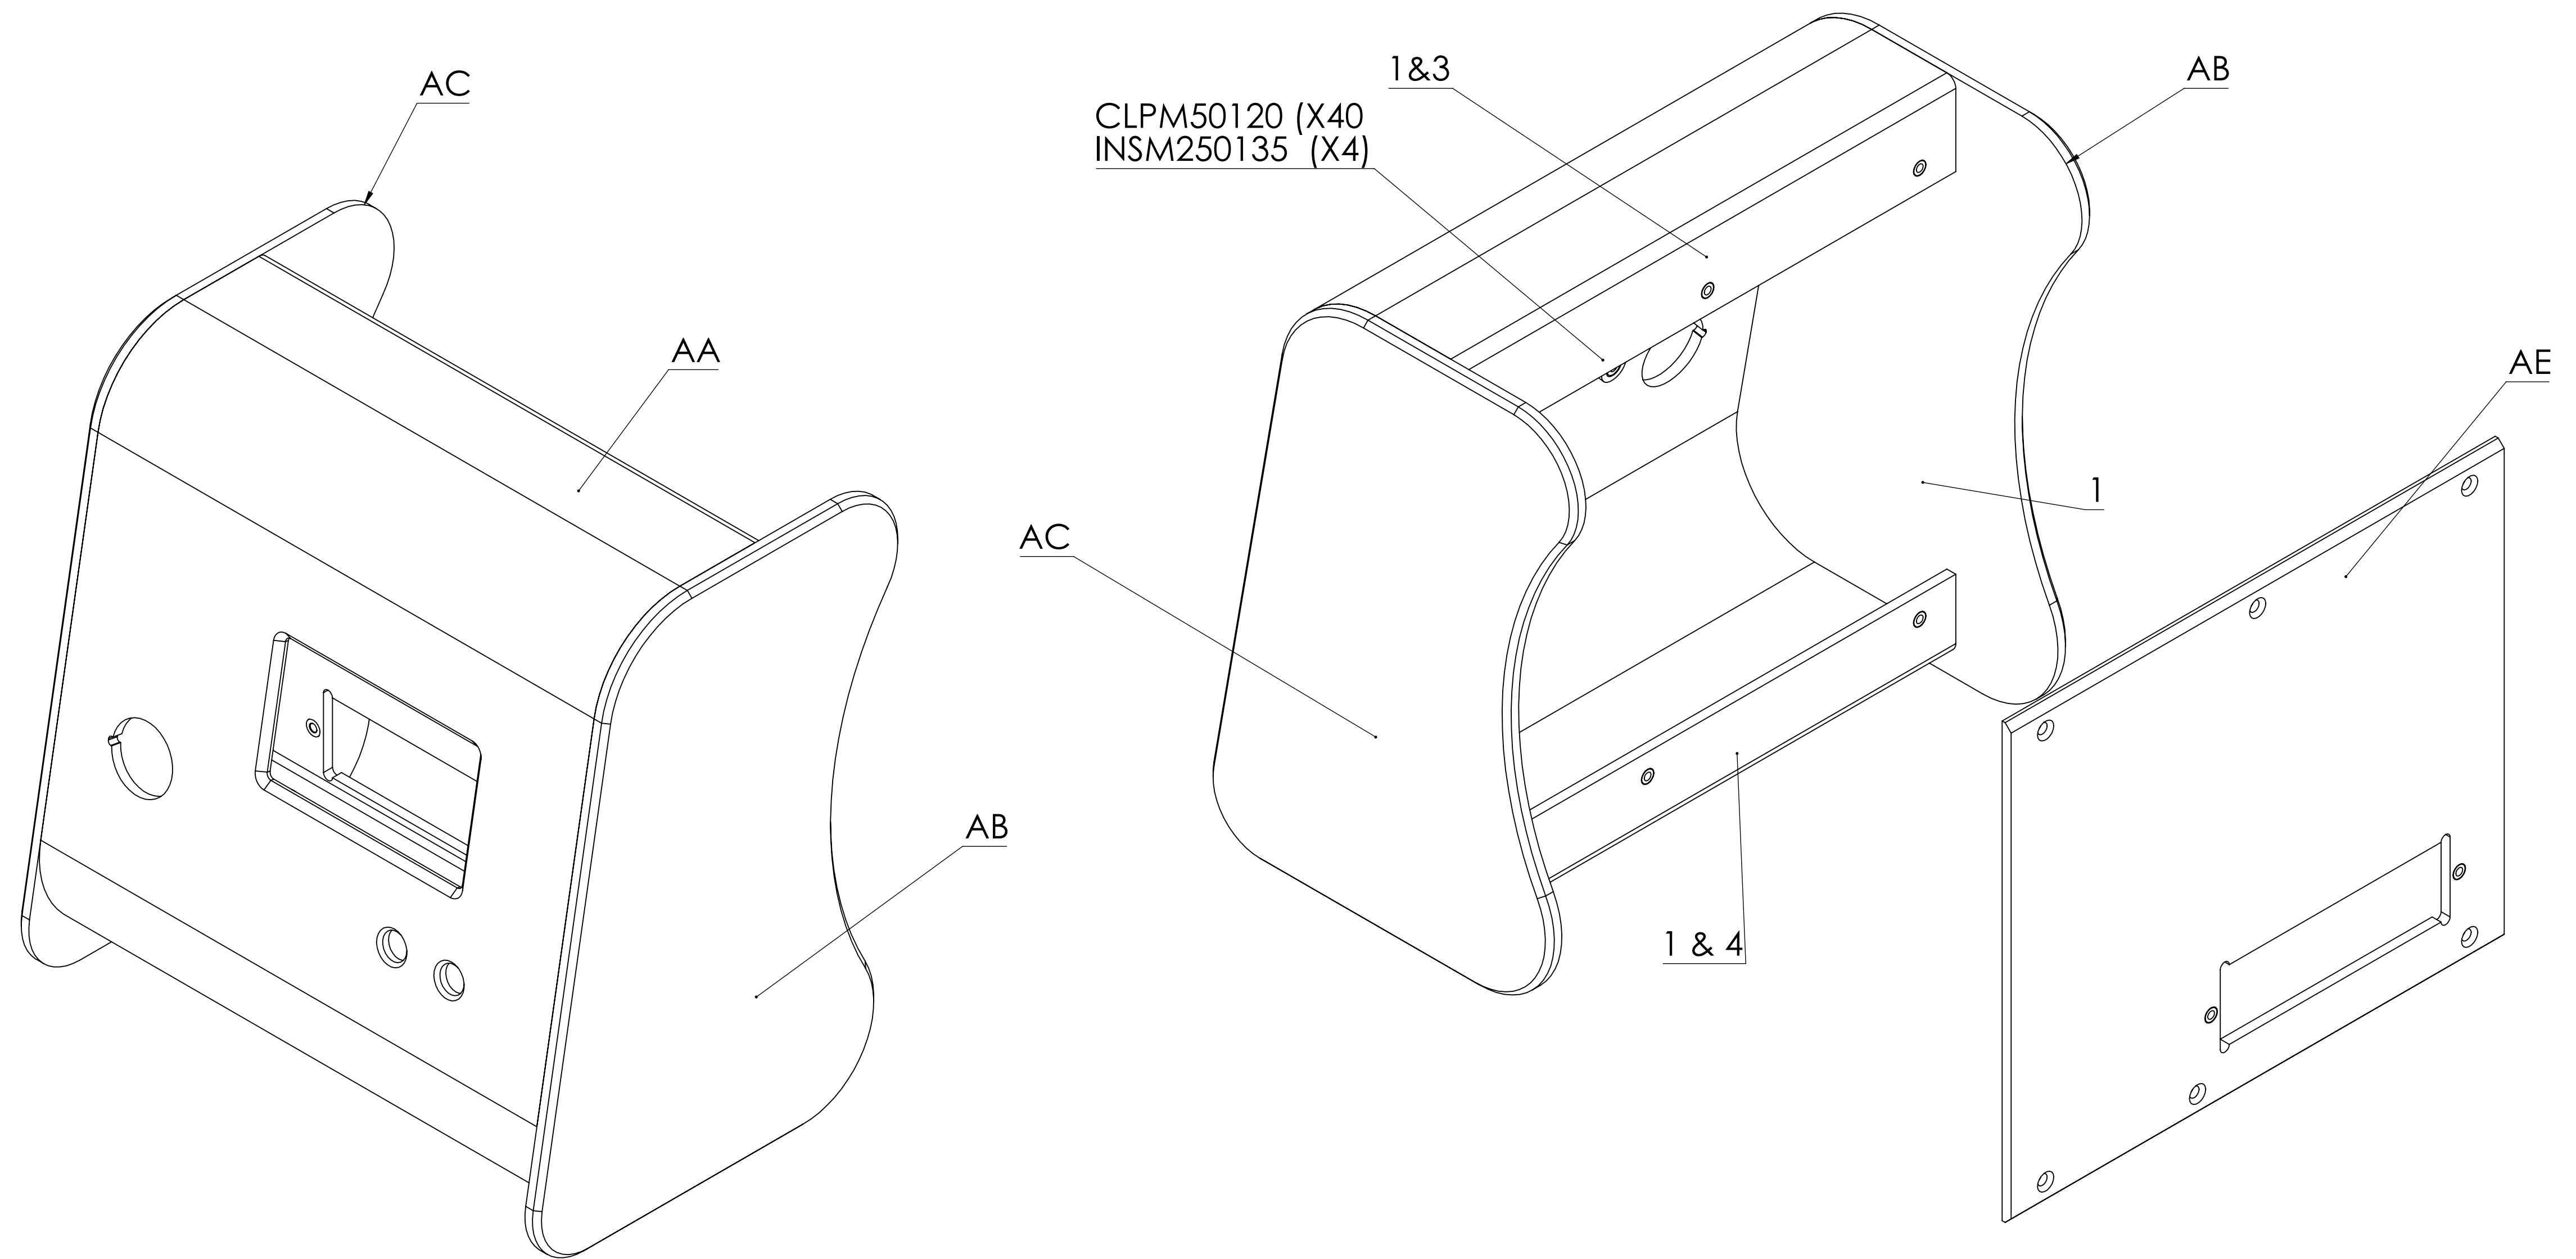

1. REMOVED SIDE MOUNTING RAILS.
2. ADDED INSERTS FOR REAR PANEL MOUNT TOP AND BOTTOM.
3. INCREASED TOP FLANGE FROM 12mm TO 20
4. INCREASED BOTTOM FLANGE FROM 12 TO 24mm

TOOLLESS DRAWING
 JOB# 6941
 JOB NAME: CAROLON
 PROJECT: SMART READER
 DIMENSIONS IN mm
 MATERIAL: OFF 3mm WHITE ABS, 4mm BLACK ABS
 DESIGNER: SONYA BAILEY
 DATE DRAWN: 12/15/2016
 SHEET 3 OF 3